

**BOROUGH OF TRAFFORD (PROHIBITION OF WAITING AND LOADING AND PROVISION OF PARKING) ORDER 2001 (AMENDMENT NO 162)(PART A) ORDER 2014**

**NOTICE IS HEREBY GIVEN** that Trafford Borough Council has made an Order under the Road Traffic Regulation Act 1984, as amended.

The effect of the Order will be to amend the Borough of Trafford (Prohibition of Waiting and Loading and Provision of Parking) Order 2001, as amended ("the 2001 Order") by the introduction or removal of the following provisions:

- a) No Waiting At Any Time Code - 7A

on the lengths of roads specified in Schedules 1 and 2 hereto by the addition, to the Schedule to the 2001 Order, of the lengths of road specified in Schedules 1a and 1b below and by the removal, from the Schedule to the 2001 Order, of the lengths of road specified in Schedules 2a and 2b below.

**SCHEDULE 1**

**Schedule 1a - Proposed**

Street	Side	From	To	Code
Brixham Road, Stretford	both	its junction with Ayres Road	its southern extent	7A

**Schedule 1b - Proposed**

Street	Side	From	To	Code
Jackson Street, Stretford	north	a point 15 metres west of its junction with Cyprus Street	to its junction with Cyprus Street	7A

**SCHEDULE 2**

**Schedule 2a - Revoked**

Street	Side	From	To	Code
Brixham Road, Stretford	east	its junction with Ayres Road	a point 15 metres east of its junction with Ayres Road	7A

**Schedule 2b - Revoked**

Street	Side	From	To	Code
Jackson Street, Stretford	north	a point 33 metres west of its junction with Cyprus Street	to its junction with Cyprus Street	7A

The proposals for the Meadway Area, and Stamford Street, Sale, Bath Crescent & Stanley Road, Old Trafford and Brixham Road, Warwick Court, Radnor Street & Urmston Lane, Stretford which were advertised at the same time as the above will be the subject of a future part order or abandoned.

The Order will come into operation on 9<sup>th</sup> October 2014, and a copy, together with a map showing the lengths of road to which it relates may be inspected at Stretford Library Information Desk and at Access Trafford, Sale Waterside, Sale during their normal opening hours.

The Notice and plans can also be viewed online at: <http://www.trafford.gov.uk/residents/transport-and-streets/roads-highways-and-pavements/traffic-regulation-orders.aspx>

If you wish to question the validity of the Order or any provision contained in it on the grounds that it is not within the powers contained in the Road Traffic Regulation Act 1984, or that any requirement of that Act or of any instrument made under it has not been complied with in relation to the Order you may, within six weeks from 3<sup>rd</sup> October 2014 apply to the High Court for that purpose.

Dated: 8 October 2014

Head of Highways,  
Trafford Council,  
Waterside House,  
Sale,  
M33 7ZF

**BOROUGH OF TRAFFORD (PROHIBITION OF WAITING AND LOADING AND PROVISION OF PARKING) ORDER 2001 (AMENDMENT NO 162)(PART A) ORDER 2014**

**NOTICE IS HEREBY GIVEN** that Trafford Borough Council has made an Order under the Road Traffic Regulation Act 1984, as amended.

The effect of the Order will be to amend the Borough of Trafford (Prohibition of Waiting and Loading and Provision of Parking) Order 2001, as amended ("the 2001 Order") by the introduction or removal of waiting restrictions on lengths of Brixham Road and Jackson Street, Stretford.

The proposals for the Meadway Area, and Stamford Street, Sale, Bath Crescent & Stanley Road, Old Trafford and Brixham Road, Warwick Court, Radnor Street & Urmston Lane, Stretford which were advertised at the same time as the above will be the subject of a future part order or abandoned.


The Order will come into operation on 9<sup>th</sup> October 2014, and a copy, together with a map showing the lengths of road to which it relates may be inspected at Stretford Library Information Desk and at Access Trafford, Sale Waterside, Sale during their normal opening hours.

The Notice and plans can also be viewed online at: <http://www.trafford.gov.uk/residents/transport-and-streets/roads-highways-and-pavements/traffic-regulation-orders.aspx>


If you wish to question the validity of the Order or any provision contained in it on the grounds that it is not within the powers contained in the Road Traffic Regulation Act 1984, or that any requirement of that Act or of any instrument made under it has not been complied with in relation to the Order you may, within six weeks from 3<sup>rd</sup> October 2014 apply to the High Court for that purpose.

Dated: 8 October 2014

Head of Highways, Trafford Borough Council, Waterside House, Sale Waterside, Sale, M33 7ZF

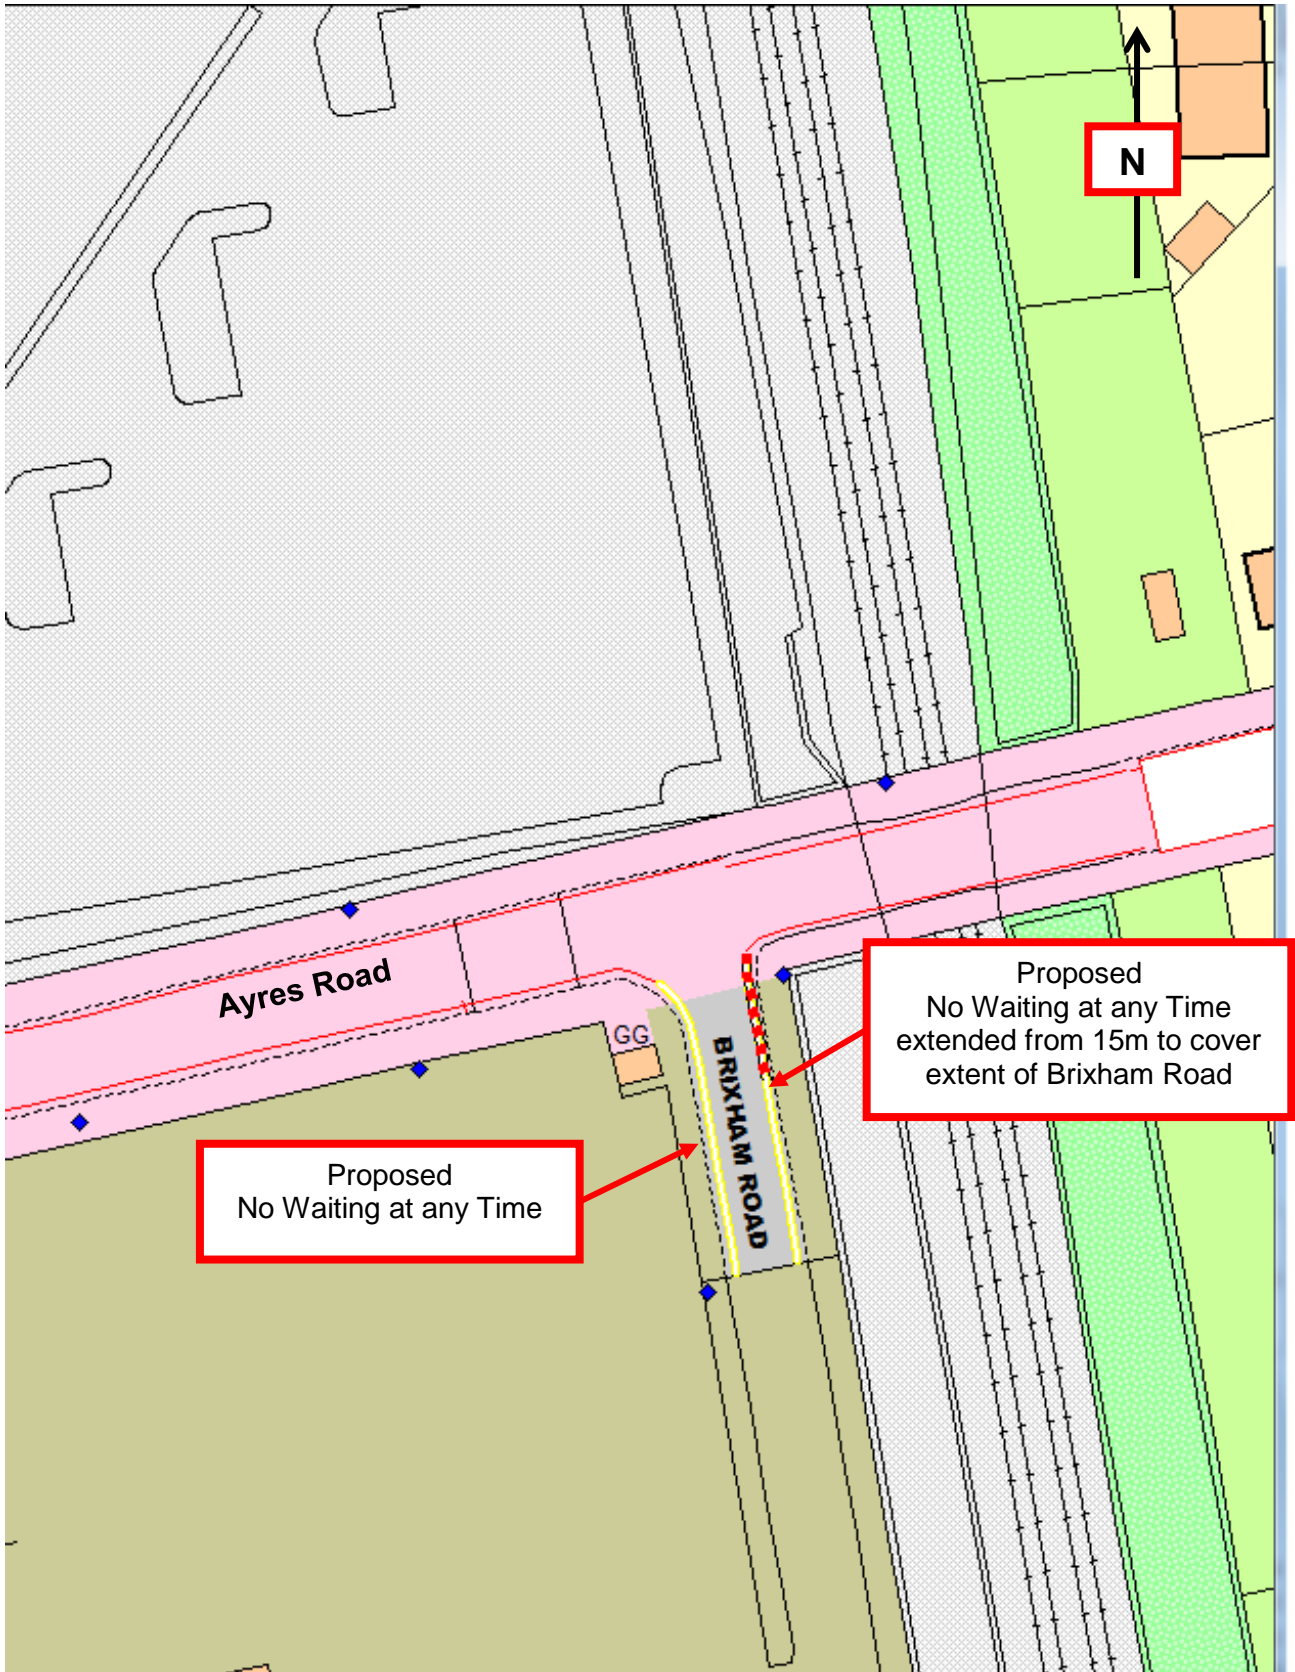

Drawing E8912 – Sheet 2 of 6  
Existing restrictions indicated in red.

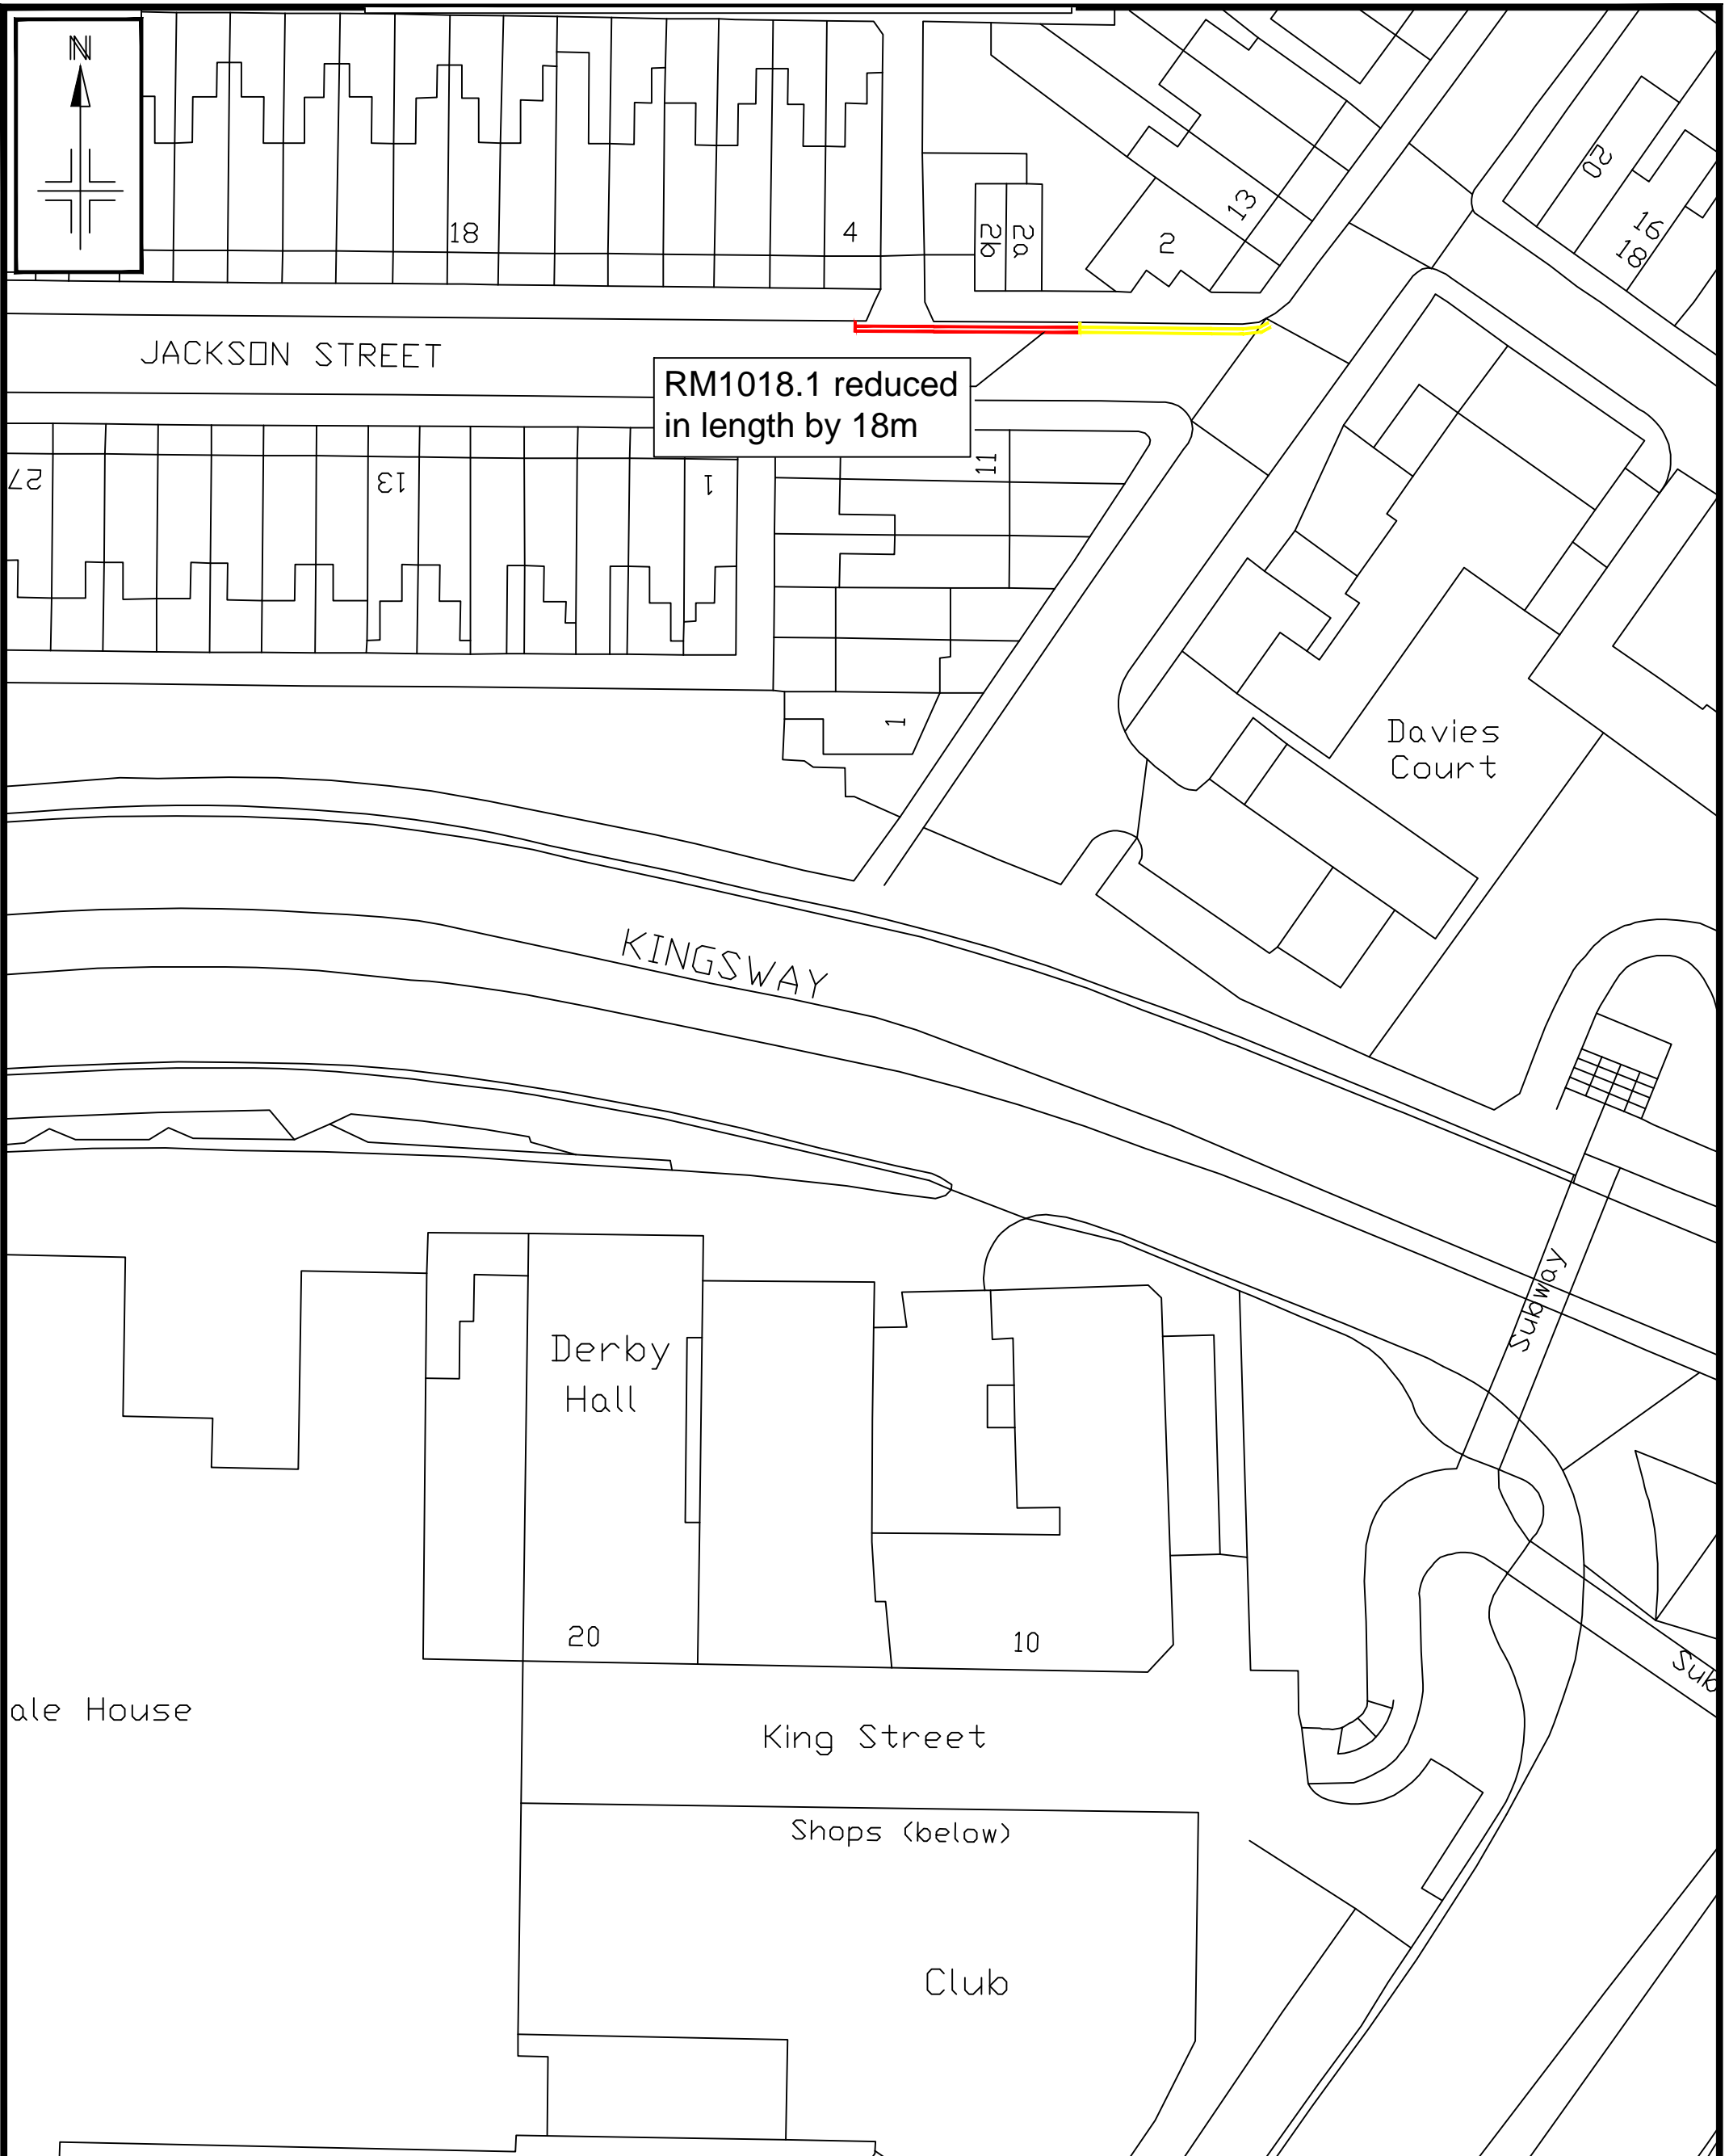

RM1018.1 reduced  
in length by 18m

Notes:  
No Dimensions to be scaled from  
this drawing. All Dimensions are  
to be checked on site.

REV.	DATE	REVISION DETAILS	DRAWN	CHECKED	APPROVED

PROJECT & TITLE  
**Str02 - Stretford and  
 Old Trafford Areas**  
 TRO Lining Details



DRAWN <b>DO</b>	CHECKED <b>JS</b>	APPROVED <b>KW</b>
SCALE <b>NTS</b>	DRAWING NO. <b>60313721-TRAF02-L-20</b>	
DATE <b>Aug 14</b>	REVISION <b>-</b>	
FILE PATH R:\BU\Environment\Built Environment\Traffic & Transportation\FILES - Schemes\AECOM3 - Stretford\CAD		